
1

ELEVATION - BREAK ROOM 201 1/2" = 1'-0" RE: 3/A-501

 

2

SECTION - BREAK ROOM 201 RE: 4/A-501




CASEWORK ELEVATIONS

M.02

1

ELEVATION - RECEPTION 105 1/2" = 1'-0" RE: C4/A-458

 

QZ-1 QUARTZ TOP

CASEWORK ELEVATIONS

M.03